

U.S. Army Corps of Engineers Los Angeles District

Permit Inquiries Checklist

I have a question if my project would require a permit for:

Section 404: Section 10/103: Section 408: I do not know:

Contact Name: _____ Phone: _____ Email: _____

Project Name:

Project Applicant (Name of Agency / Company/ Persons proposing the project):

Project Location: Street Address: _____

APN (if known): _____ City: _____ County: _____

Latitude (in decimal degrees, i.e. 1.11): _____

Longitude (in decimal degrees, i.e. -1.11): _____

Google Maps link (Google Maps pin drop location via url):

Current land ownership:

Have you contacted the County Flood Control District for a Section 408 Permit? Yes: No:

Provide contact:

Have you contacted Regulatory Division for a Section 404/10/103 Permit? Yes:

Provide contact:

Describe the Project including how you would access the site (be as detailed as possible):

- Work type (indicate all applicable): access/encroachment channel levee improvement
 side drain connection dams reservoir/basin modification investigations/surveys
 bridges utility crossings landscaping improvements recreational trails
 environmental restoration coastal features gravel mining dredging
 new construction major repairs maintenance installation

Other work type (if other work type, explain):

Attach a Project Location Map, a Project Footprint Map, and site photos.

Please send this information to SPLPermitInquiries@usace.army.mil. Please keep emails to less than 20MB. You can send attachments in multiple emails, if needed.

STATE OF CALIFORNIA - DEPARTMENT OF TRANSPORTATION
Caltrans
 DESIGN

FUNCTIONAL SUPERVISOR: SAM ALAMEDDINE
 REVISIONS: LE NGUYEN, RYAN HOANG, REVISED BY, DATE REVISION
 CALCULATED/DESIGNED BY, CHECKED BY

NOTES:

- "FOR BROADBAND MIDDLE MILE NETWORK WORK ONLY"
- FOR ACCURATE RIGHT OF WAY DATA, CONTACT RIGHT OF WAY ENGINEERING AT THE DISTRICT OFFICE.
- MINIMUM OF 2 FEET OF LATERAL AND VERTICAL CLEARANCE FROM THE EXISTING, DRAINAGE FACILITIES BUT NOT LIMIT TO EARTH DITCHES, CONCRETE DITCHES, OPEN CHANNELS, DRAINS, CULVERTS, MANHOLES, INLET RSP, BMP's, PUMP STATIONS, OR ANY DRAINAGE SYSTEMS.
- UTILILITY INFORMATION IS INCOMPLETE EXISTING HIGH PRIORITY UTILITIES AND OTHER UTILITIES HAVE ONLY BEEN POSITIVELY LOCATED AT SPOT LOCATIONS.


VAULT LOCATIONS

VAULT No.	NORTHING	EASTING
116	1777644.608	6528829.222
117	1777443.947	6528828.722
118	1777370.607	6529183.173

Dist	COUNTY	ROUTE	POST MILES TOTAL PROJECT	SHEET No.	TOTAL SHEETS
07	LA	91	R6.1/R20.7		

REGISTERED CIVIL ENGINEER DATE _____
 PLANS APPROVAL DATE _____

THE STATE OF CALIFORNIA OR ITS OFFICERS OR AGENTS SHALL NOT BE RESPONSIBLE FOR THE ACCURACY OR COMPLETENESS OF SCANNED COPIES OF THIS PLAN SHEET.

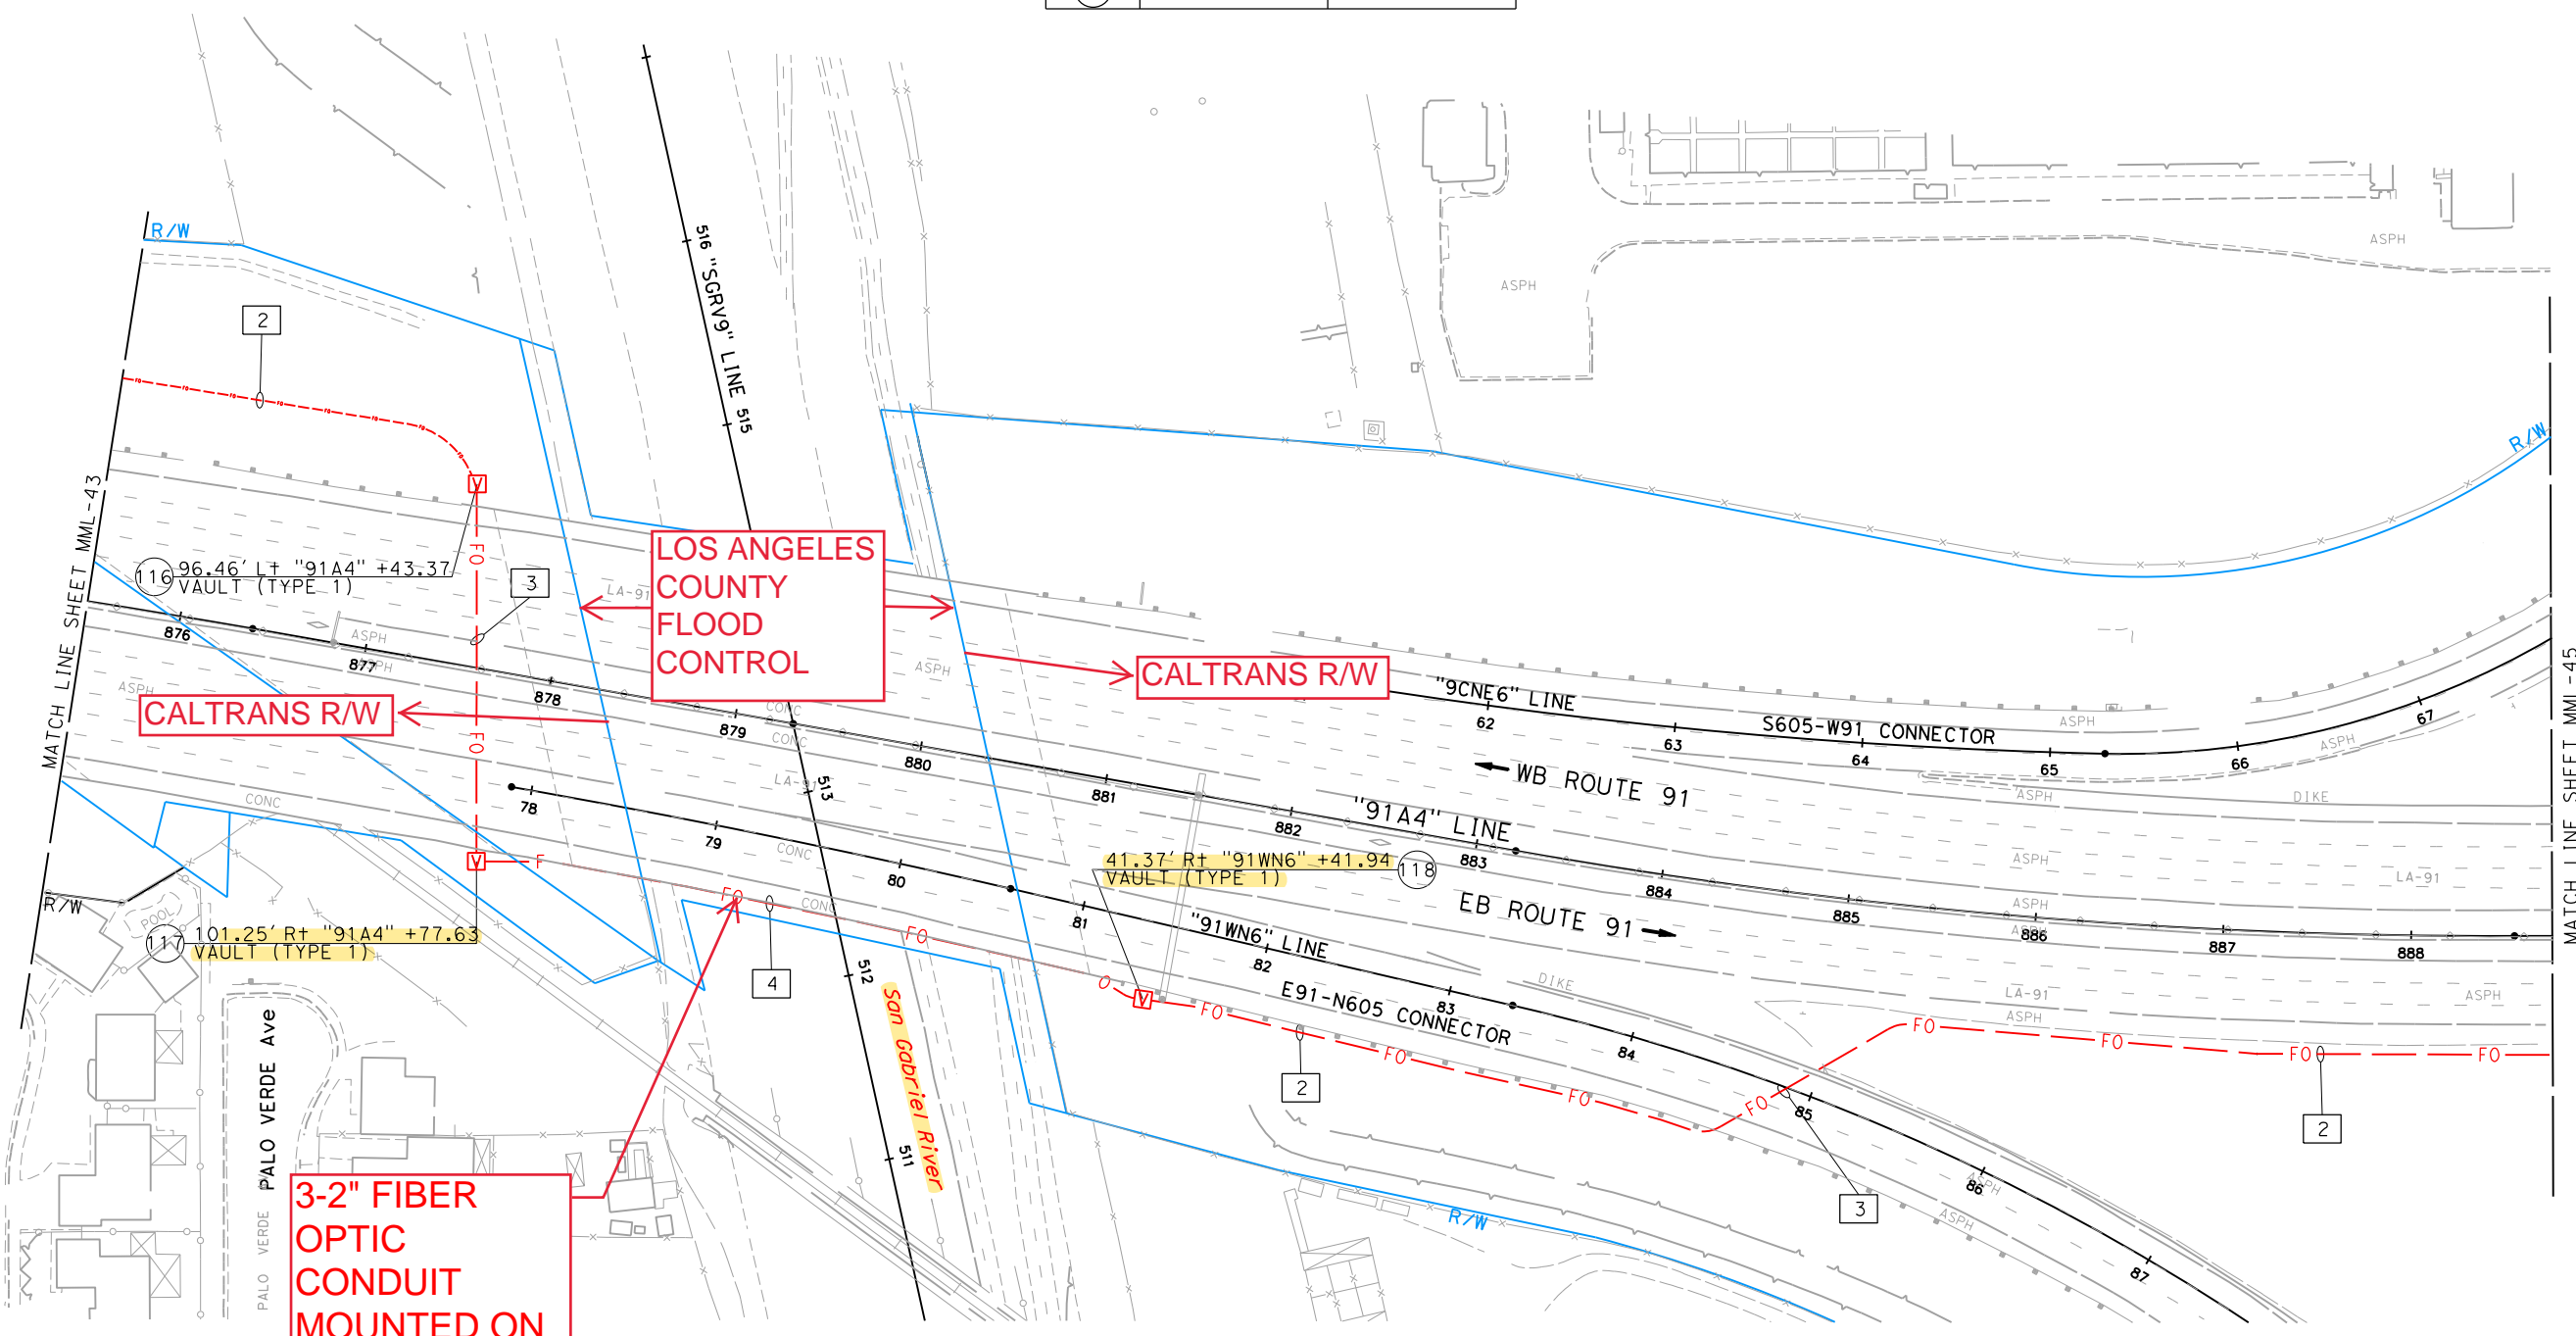

116 96.46' Lt "91A4" +43.37 VAULT (TYPE 1)

CALTRANS R/W

LOS ANGELES COUNTY FLOOD CONTROL

CALTRANS R/W



117 101.25' Rt "91A4" +77.63 VAULT (TYPE 1)

3-2" FIBER OPTIC CONDUIT MOUNTED ON STRUCTURE


118 41.37' Rt "91WN6" +41.94 VAULT (TYPE 1)

LAYOUT
 SCALE: 1" = 50'

MML - 44

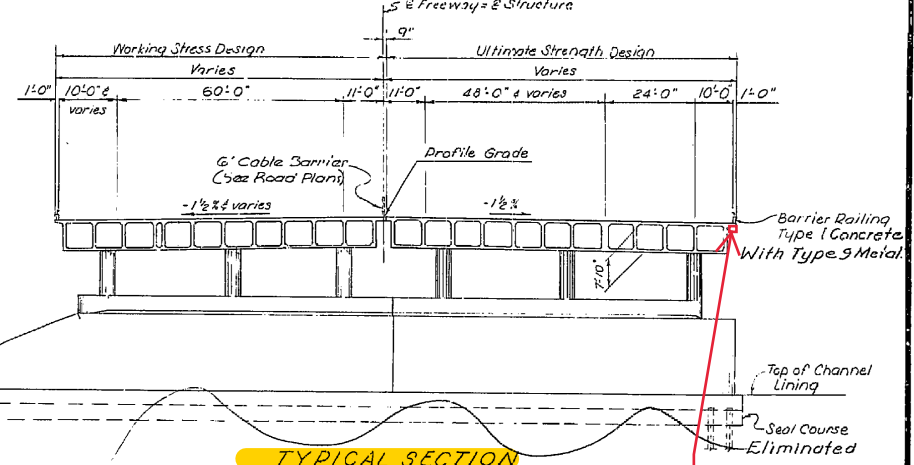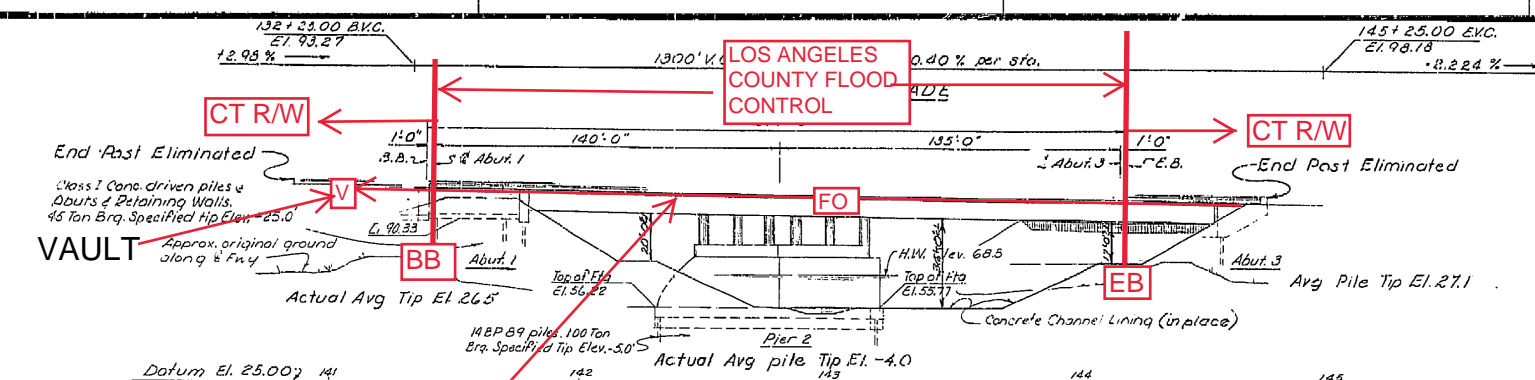

AS BUILT PLANS
Contract No. 07-009524
Date Completed _____
Document No. 70000 381

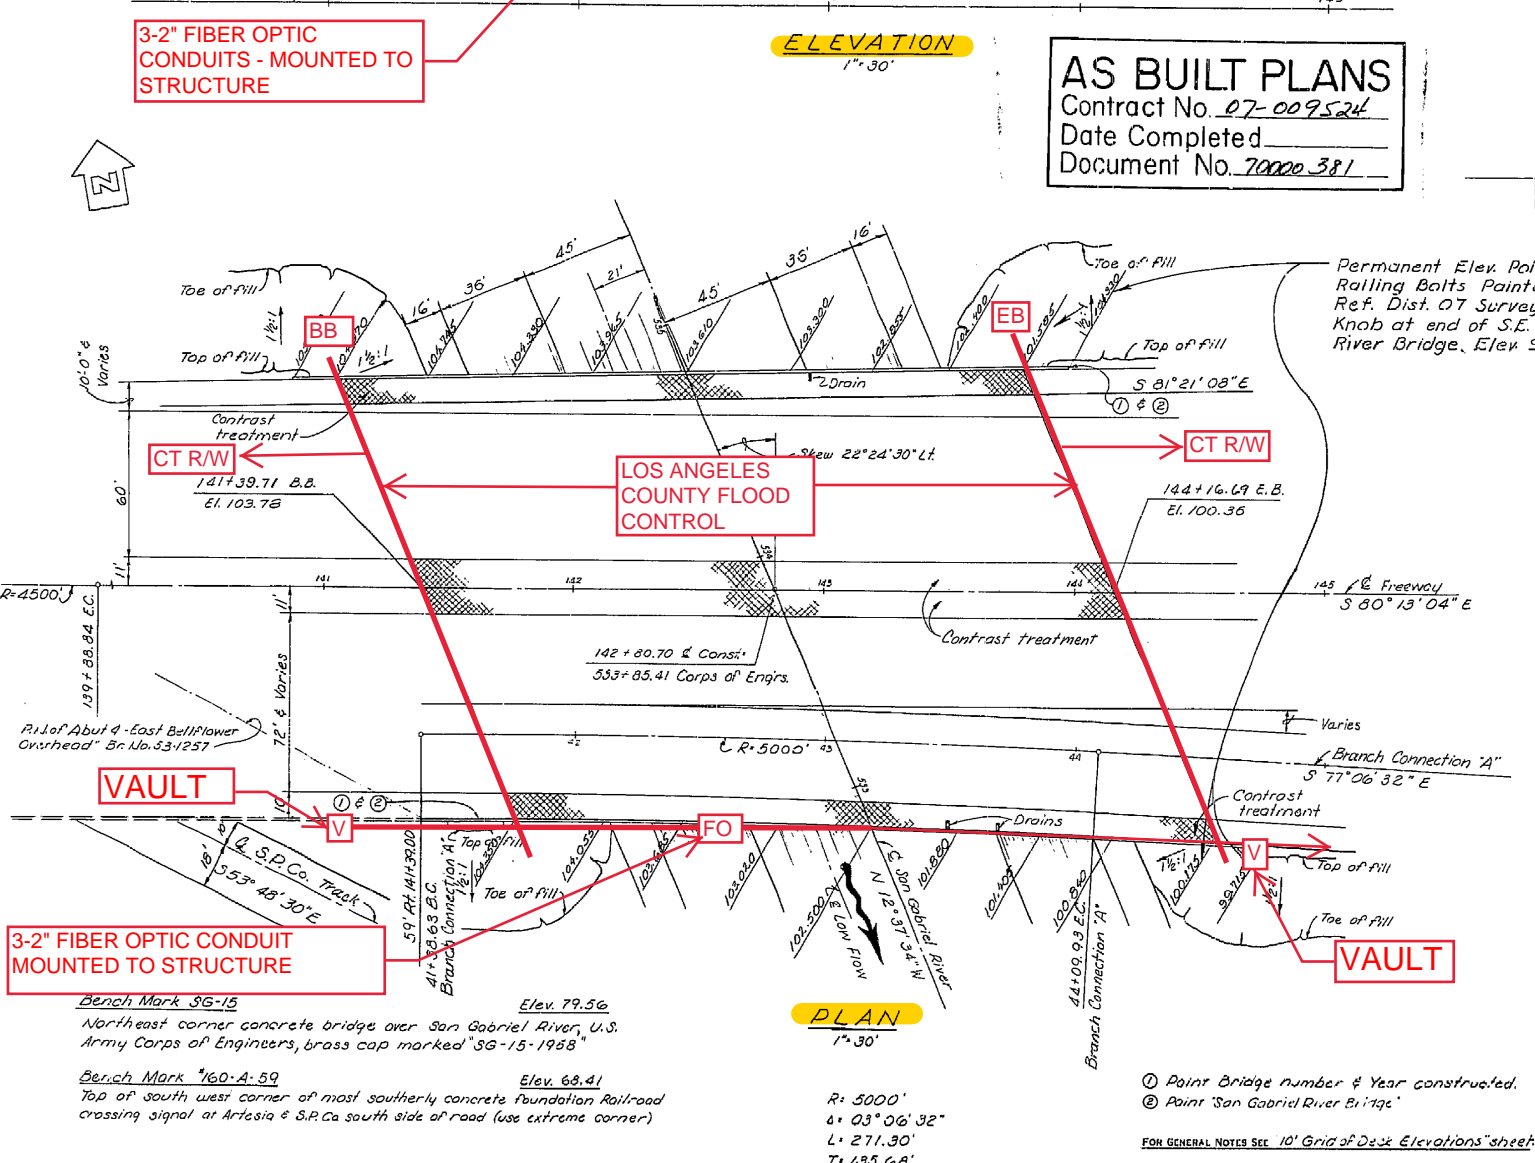

Permanent Elev. Points Chis. ts on Barrier
Rolling Bolts Painted Red.
Ref. Dist. 07 Survey BM #144-E-68-Chis.
Knob at end of S.E. Wingwall, San Gabriel
River Bridge, Elev. 97.719

APPROXIMATE QUANTITIES

REMOVING AND REPLACING CHANNEL LINING	3144	4,980 SF
STRUCTURE EXCAVATION (BRIDGE)	605	CY
STRUCTURE EXCAVATION (TYPE "A")	296.41	450 CY
STRUCTURE BACKFILL (BRIDGE)	350	CY
PERVIOUS BACKFILL MATERIAL	15	CY
FURNISHING CONCRETE PILING (CLASS 1)	6,142.3	4,340 LF
FURNISHING STEEL PILING (148P89)	4561.9	4,640 LF
DRIVING CONCRETE PILES	99	EA
DRIVING STEEL PILES	81	EA
CLASS "A" CONCRETE (BRIDGE)	4,415	CY
CLASS "A" CONCRETE (FOOTING BLOCK)	291.91	645 CY
WATERSTOPS	21	48 LF
BAR REINFORCING STEEL (BRIDGE)	702,000	LBS.
BAR REINFORCING STEEL (A-32)(60,000 PSI)	566,000	LBS.
MISCELLANEOUS METAL (BRIDGE)	834	900 LBS.
CONTRAST TREATMENT	12.93	1,300-SY
BARRIER RAILING (TYPE 1) Concrete With Type 9 Metal	649.3	648 LF

*FINAL QUANTITIES

INDEX TO PLANS

Sheet No.	Title
1	General Plan
2	10' Grid of Deck Elevations
3	Foundation Plan
4	Abutment Details
5	Pier Details
6	Pier Details-Left Structure
7	Pier Details-Right Structure
8	Pier Wall & Loose Details
9	Typical Section
10	Girder Layout-Left Structure
11	Girder Layout-Right Structure
12	Girder Reinforcement-Left Structure
13	Girder Reinforcement-Right Structure
14	Deck Drain Details
15	Log of Test Borings

3-1 --- Box Girder Details No.1
3-2 --- Type 1 Retaining Wall
3-3 --- Retaining Wall Details No.1
3-4 --- Barrier Railing Type 1
3-5 --- Barrier Rollings Details
3-6 --- Concrete Pile Det 3/15

See Route 9/14 Sep. for
Barrier Railing Detail's Steel Post

AS BUILT
CORRECTIONS BY La Faustina WEW
CONTRACT NO. 07-009524
Date 8-28-69/4-28-69

Bench Mark 36-15 Elev. 79.56
Northeast corner concrete bridge over San Gabriel River, U.S.
Army Corps of Engineers, brass cap marked "36-15-1958"

Bench Mark 160-A-59 Elev. 68.41
Top of south west corner of most southerly concrete foundation Railroad
crossing signal at Artesia & S.P. Co. south side of road (use extreme corner)

PLAN 1"=30"

R=5000'
Δ=03°06'32"
L=271.30'
T=135.68'

① Point Bridge number & Year constructed.
② Point "San Gabriel River Bridge"

FOR GENERAL NOTES SEE "10' Grid of Deck Elevations" sheet.

LIVE LOADING H20-S16-44 AND ALTERNATIVE

BRIDGE DEPARTMENT	DESIGN SECTION	6
Section Supervisor: H.P. [Signature]	Project Designer: [Signature]	
DESIGN	BY: [Signature]	CHECKED: [Signature]
DETAILS	BY: [Signature]	CHECKED: [Signature]
LAYOUT	BY: [Signature]	CHECKED: [Signature]
QUANTITIES	BY: [Signature]	CHECKED: [Signature]
SPECIFICATIONS	BY: [Signature]	CHECKED: [Signature]
Approved & Recommended by: [Signature]	Scale: 1"=30'	1"=20'

STATE OF CALIFORNIA
DEPARTMENT OF PUBLIC WORKS
DIVISION OF HIGHWAYS

SAN GABRIEL RIVER BRIDGE

LOCATED IN THE CITY OF BELLSFLOWER & DAIRY VALLEY APPROX. 0.4 MI. N. OF ARTESIA BLVD. & 0.5 MI. W. OF STUDEBAKER ROAD OVER THE SAN GABRIEL RIVER CHANNEL IN LOS ANGELES COUNTY

GENERAL PLAN

SCALE AS NOTED BRIDGE 53-1698 FILE DRAWING 531698-1

PRELIMINARY DRAWING NO. P. REVISION DATES: 12/66, 1/67, 2/67, 3/67, 4/67, 5/67, 6/67, 7/67, 8/67, 9/67, 10/67, 11/67, 12/67, 1/68, 2/68, 3/68, 4/68, 5/68, 6/68, 7/68, 8/68, 9/68, 10/68, 11/68, 12/68, 1/69, 2/69, 3/69, 4/69, 5/69, 6/69, 7/69, 8/69, 9/69, 10/69, 11/69, 12/69, 1/70, 2/70, 3/70, 4/70, 5/70, 6/70, 7/70, 8/70, 9/70, 10/70, 11/70, 12/70, 1/71, 2/71, 3/71, 4/71, 5/71, 6/71, 7/71, 8/71, 9/71, 10/71, 11/71, 12/71, 1/72, 2/72, 3/72, 4/72, 5/72, 6/72, 7/72, 8/72, 9/72, 10/72, 11/72, 12/72, 1/73, 2/73, 3/73, 4/73, 5/73, 6/73, 7/73, 8/73, 9/73, 10/73, 11/73, 12/73, 1/74, 2/74, 3/74, 4/74, 5/74, 6/74, 7/74, 8/74, 9/74, 10/74, 11/74, 12/74, 1/75, 2/75, 3/75, 4/75, 5/75, 6/75, 7/75, 8/75, 9/75, 10/75, 11/75, 12/75, 1/76, 2/76, 3/76, 4/76, 5/76, 6/76, 7/76, 8/76, 9/76, 10/76, 11/76, 12/76, 1/77, 2/77, 3/77, 4/77, 5/77, 6/77, 7/77, 8/77, 9/77, 10/77, 11/77, 12/77, 1/78, 2/78, 3/78, 4/78, 5/78, 6/78, 7/78, 8/78, 9/78, 10/78, 11/78, 12/78, 1/79, 2/79, 3/79, 4/79, 5/79, 6/79, 7/79, 8/79, 9/79, 10/79, 11/79, 12/79, 1/80, 2/80, 3/80, 4/80, 5/80, 6/80, 7/80, 8/80, 9/80, 10/80, 11/80, 12/80, 1/81, 2/81, 3/81, 4/81, 5/81, 6/81, 7/81, 8/81, 9/81, 10/81, 11/81, 12/81, 1/82, 2/82, 3/82, 4/82, 5/82, 6/82, 7/82, 8/82, 9/82, 10/82, 11/82, 12/82, 1/83, 2/83, 3/83, 4/83, 5/83, 6/83, 7/83, 8/83, 9/83, 10/83, 11/83, 12/83, 1/84, 2/84, 3/84, 4/84, 5/84, 6/84, 7/84, 8/84, 9/84, 10/84, 11/84, 12/84, 1/85, 2/85, 3/85, 4/85, 5/85, 6/85, 7/85, 8/85, 9/85, 10/85, 11/85, 12/85, 1/86, 2/86, 3/86, 4/86, 5/86, 6/86, 7/86, 8/86, 9/86, 10/86, 11/86, 12/86, 1/87, 2/87, 3/87, 4/87, 5/87, 6/87, 7/87, 8/87, 9/87, 10/87, 11/87, 12/87, 1/88, 2/88, 3/88, 4/88, 5/88, 6/88, 7/88, 8/88, 9/88, 10/88, 11/88, 12/88, 1/89, 2/89, 3/89, 4/89, 5/89, 6/89, 7/89, 8/89, 9/89, 10/89, 11/89, 12/89, 1/90, 2/90, 3/90, 4/90, 5/90, 6/90, 7/90, 8/90, 9/90, 10/90, 11/90, 12/90, 1/91, 2/91, 3/91, 4/91, 5/91, 6/91, 7/91, 8/91, 9/91, 10/91, 11/91, 12/91, 1/92, 2/92, 3/92, 4/92, 5/92, 6/92, 7/92, 8/92, 9/92, 10/92, 11/92, 12/92, 1/93, 2/93, 3/93, 4/93, 5/93, 6/93, 7/93, 8/93, 9/93, 10/93, 11/93, 12/93, 1/94, 2/94, 3/94, 4/94, 5/94, 6/94, 7/94, 8/94, 9/94, 10/94, 11/94, 12/94, 1/95, 2/95, 3/95, 4/95, 5/95, 6/95, 7/95, 8/95, 9/95, 10/95, 11/95, 12/95, 1/96, 2/96, 3/96, 4/96, 5/96, 6/96, 7/96, 8/96, 9/96, 10/96, 11/96, 12/96, 1/97, 2/97, 3/97, 4/97, 5/97, 6/97, 7/97, 8/97, 9/97, 10/97, 11/97, 12/97, 1/98, 2/98, 3/98, 4/98, 5/98, 6/98, 7/98, 8/98, 9/98, 10/98, 11/98, 12/98, 1/99, 2/99, 3/99, 4/99, 5/99, 6/99, 7/99, 8/99, 9/99, 10/99, 11/99, 12/99, 1/00, 2/00, 3/00, 4/00, 5/00, 6/00, 7/00, 8/00, 9/00, 10/00, 11/00, 12/00, 1/01, 2/01, 3/01, 4/01, 5/01, 6/01, 7/01, 8/01, 9/01, 10/01, 11/01, 12/01, 1/02, 2/02, 3/02, 4/02, 5/02, 6/02, 7/02, 8/02, 9/02, 10/02, 11/02, 12/02, 1/03, 2/03, 3/03, 4/03, 5/03, 6/03, 7/03, 8/03, 9/03, 10/03, 11/03, 12/03, 1/04, 2/04, 3/04, 4/04, 5/04, 6/04, 7/04, 8/04, 9/04, 10/04, 11/04, 12/04, 1/05, 2/05, 3/05, 4/05, 5/05, 6/05, 7/05, 8/05, 9/05, 10/05, 11/05, 12/05, 1/06, 2/06, 3/06, 4/06, 5/06, 6/06, 7/06, 8/06, 9/06, 10/06, 11/06, 12/06, 1/07, 2/07, 3/07, 4/07, 5/07, 6/07, 7/07, 8/07, 9/07, 10/07, 11/07, 12/07, 1/08, 2/08, 3/08, 4/08, 5/08, 6/08, 7/08, 8/08, 9/08, 10/08, 11/08, 12/08, 1/09, 2/09, 3/09, 4/09, 5/09, 6/09, 7/09, 8/09, 9/09, 10/09, 11/09, 12/09, 1/10, 2/10, 3/10, 4/10, 5/10, 6/10, 7/10, 8/10, 9/10, 10/10, 11/10, 12/10, 1/11, 2/11, 3/11, 4/11, 5/11, 6/11, 7/11, 8/11, 9/11, 10/11, 11/11, 12/11, 1/12, 2/12, 3/12, 4/12, 5/12, 6/12, 7/12, 8/12, 9/12, 10/12, 11/12, 12/12, 1/13, 2/13, 3/13, 4/13, 5/13, 6/13, 7/13, 8/13, 9/13, 10/13, 11/13, 12/13, 1/14, 2/14, 3/14, 4/14, 5/14, 6/14, 7/14, 8/14, 9/14, 10/14, 11/14, 12/14, 1/15, 2/15, 3/15, 4/15, 5/15, 6/15, 7/15, 8/15, 9/15, 10/15, 11/15, 12/15, 1/16, 2/16, 3/16, 4/16, 5/16, 6/16, 7/16, 8/16, 9/16, 10/16, 11/16, 12/16, 1/17, 2/17, 3/17, 4/17, 5/17, 6/17, 7/17, 8/17, 9/17, 10/17, 11/17, 12/17, 1/18, 2/18, 3/18, 4/18, 5/18, 6/18, 7/18, 8/18, 9/18, 10/18, 11/18, 12/18, 1/19, 2/19, 3/19, 4/19, 5/19, 6/19, 7/19, 8/19, 9/19, 10/19, 11/19, 12/19, 1/20, 2/20, 3/20, 4/20, 5/20, 6/20, 7/20, 8/20, 9/20, 10/20, 11/20, 12/20, 1/21, 2/21, 3/21, 4/21, 5/21, 6/21, 7/21, 8/21, 9/21, 10/21, 11/21, 12/21, 1/22, 2/22, 3/22, 4/22, 5/22, 6/22, 7/22, 8/22, 9/22, 10/22, 11/22, 12/22, 1/23, 2/23, 3/23, 4/23, 5/23, 6/23, 7/23, 8/23, 9/23, 10/23, 11/23, 12/23, 1/24, 2/24, 3/24, 4/24, 5/24, 6/24, 7/24, 8/24, 9/24, 10/24, 11/24, 12/24, 1/25, 2/25, 3/25, 4/25, 5/25, 6/25, 7/25, 8/25, 9/25, 10/25, 11/25, 12/25, 1/26, 2/26, 3/26, 4/26, 5/26, 6/26, 7/26, 8/26, 9/26, 10/26, 11/26, 12/26, 1/27, 2/27, 3/27, 4/27, 5/27, 6/27, 7/27, 8/27, 9/27, 10/27, 11/27, 12/27, 1/28, 2/28, 3/28, 4/28, 5/28, 6/28, 7/28, 8/28, 9/28, 10/28, 11/28, 12/28, 1/29, 2/29, 3/29, 4/29, 5/29, 6/29, 7/29, 8/29, 9/29, 10/29, 11/29, 12/29, 1/30, 2/30, 3/30, 4/30, 5/30, 6/30, 7/30, 8/30, 9/30, 10/30, 11/30, 12/30, 1/31, 2/31, 3/31, 4/31, 5/31, 6/31, 7/31, 8/31, 9/31, 10/31, 11/31, 12/31, 1/32, 2/32, 3/32, 4/32, 5/32, 6/32, 7/32, 8/32, 9/32, 10/32, 11/32, 12/32, 1/33, 2/33, 3/33, 4/33, 5/33, 6/33, 7/33, 8/33, 9/33, 10/33, 11/33, 12/33, 1/34, 2/34, 3/34, 4/34, 5/34, 6/34, 7/34, 8/34, 9/34, 10/34, 11/34, 12/34, 1/35, 2/35, 3/35, 4/35, 5/35, 6/35, 7/35, 8/35, 9/35, 10/35, 11/35, 12/35, 1/36, 2/36, 3/36, 4/36, 5/36, 6/36, 7/36, 8/36, 9/36, 10/36, 11/36, 12/36, 1/37, 2/37, 3/37, 4/37, 5/37, 6/37, 7/37, 8/37, 9/37, 10/37, 11/37, 12/37, 1/38, 2/38, 3/38, 4/38, 5/38, 6/38, 7/38, 8/38, 9/38, 10/38, 11/38, 12/38, 1/39, 2/39, 3/39, 4/39, 5/39, 6/39, 7/39, 8/39, 9/39, 10/39, 11/39, 12/39, 1/40, 2/40, 3/40, 4/40, 5/40, 6/40, 7/40, 8/40, 9/40, 10/40, 11/40, 12/40, 1/41, 2/41, 3/41, 4/41, 5/41, 6/41, 7/41, 8/41, 9/41, 10/41, 11/41, 12/41, 1/42, 2/42, 3/42, 4/42, 5/42, 6/42, 7/42, 8/42, 9/42, 10/42, 11/42, 12/42, 1/43, 2/43, 3/43, 4/43, 5/43, 6/43, 7/43, 8/43, 9/43, 10/43, 11/43, 12/43, 1/44, 2/44, 3/44, 4/44, 5/44, 6/44, 7/44, 8/44, 9/44, 10/44, 11/44, 12/44, 1/45, 2/45, 3/45, 4/45, 5/45, 6/45, 7/45, 8/45, 9/45, 10/45, 11/45, 12/45, 1/46, 2/46, 3/46, 4/46, 5/46, 6/46, 7/46, 8/46, 9/46, 10/46, 11/46, 12/46, 1/47, 2/47, 3/47, 4/47, 5/47, 6/47, 7/47, 8/47, 9/47, 10/47, 11/47, 12/47, 1/48, 2/48, 3/48, 4/48, 5/48, 6/48, 7/48, 8/48, 9/48, 10/48, 11/48, 12/48, 1/49, 2/49, 3/49, 4/49, 5/49, 6/49, 7/49, 8/49, 9/49, 10/49, 11/49, 12/49, 1/50, 2/50, 3/50, 4/50, 5/50, 6/50, 7/50, 8/50, 9/50, 10/50, 11/50, 12/50, 1/51, 2/51, 3/51, 4/51, 5/51, 6/51, 7/51, 8/51, 9/51, 10/51, 11/51, 12/51, 1/52, 2/52, 3/52, 4/52, 5/52, 6/52, 7/52, 8/52, 9/52, 10/52, 11/52, 12/52, 1/53, 2/53, 3/53, 4/53, 5/53, 6/53, 7/53, 8/53, 9/53, 10/53, 11/53, 12/53, 1/54, 2/54, 3/54, 4/54, 5/54, 6/54, 7/54, 8/54, 9/54, 10/54, 11/54, 12/54, 1/55, 2/55, 3/55, 4/55, 5/55, 6/55, 7/55, 8/55, 9/55, 10/55, 11/55, 12/55, 1/56, 2/56, 3/56, 4/56, 5/56, 6/56, 7/56, 8/56, 9/56, 10/56, 11/56, 12/56, 1/57, 2/57, 3/57, 4/57, 5/57, 6/57, 7/57, 8/57, 9/57, 10/57, 11/57, 12/57, 1/58, 2/58, 3/58, 4/58, 5/58, 6/58, 7/58, 8/58, 9/58, 10/58, 11/58, 12/58, 1/59, 2/59, 3/59, 4/59, 5/59, 6/59, 7/59, 8/59, 9/59, 10/59, 11/59, 12/59, 1/60, 2/60, 3/60, 4/60, 5/60, 6/60, 7/60, 8/60, 9/60, 10/60, 11/60, 12/60, 1/61, 2/61, 3/61, 4/61, 5/61, 6/61, 7/61, 8/61, 9/61, 10/61, 11/61, 12/61, 1/62, 2/62, 3/62, 4/62, 5/62, 6/62, 7/62, 8/62, 9/62, 10/62, 11/62, 12/62, 1/63, 2/63, 3/63, 4/63, 5/63, 6/63, 7/63, 8/63, 9/63, 10/63, 11/63, 12/63, 1/64, 2/64, 3/64, 4/64, 5/64, 6/64, 7/64, 8/64, 9/64, 10/64, 11/64, 12/64, 1/65, 2/65, 3/65, 4/65, 5/65, 6/65, 7/65, 8/65, 9/65, 10/65, 11/65, 12/65, 1/66, 2/66, 3/66, 4/66, 5/66, 6/66, 7/66, 8/66, 9/66, 10/66, 11/66, 12/66, 1/67, 2/67, 3/67, 4/67, 5/67, 6/67, 7/67, 8/67, 9/67, 10/67, 11/67, 12/67, 1/68, 2/68, 3/68, 4/68, 5/68, 6/68, 7/68, 8/68, 9/68, 10/68, 11/68, 12/68, 1/69, 2/69, 3/69, 4/69, 5/69, 6/69, 7/69, 8/69, 9/69, 10/69, 11/69, 12/69, 1/70, 2/70, 3/70, 4/70, 5/70, 6/70, 7/70, 8/70, 9/70, 10/70, 11/70, 12/70, 1/71, 2/71, 3/71, 4/71, 5/71, 6/71, 7/71, 8/71, 9/71, 10/71, 11/71, 12/71, 1/72, 2/72, 3/72, 4/72, 5/72, 6/72, 7/72, 8/72, 9/72, 10/72, 11/72, 12/72, 1/73, 2/73, 3/73, 4/73, 5/73, 6/73, 7/73, 8/73, 9/73, 10/73, 11/73, 12/73, 1/74, 2/74, 3/74, 4/74, 5/74, 6/74, 7/74, 8/74, 9/74, 10/74, 11/74, 12/74, 1/75, 2/75, 3/75, 4/75, 5/75, 6/75, 7/75, 8/75, 9/75, 10/75, 11/75, 12/75, 1/76, 2/76, 3/76, 4/76, 5/76, 6/76, 7/76, 8/76, 9/76, 10/76, 11/76, 12/76, 1/77, 2/77, 3/77, 4/77, 5/77, 6/77, 7/77, 8/77, 9/77, 10/77, 11/77, 12/77, 1/78, 2/78, 3/78, 4/78, 5/78, 6/78, 7/78, 8/78, 9/78, 10/78, 11/78, 12/78, 1/79, 2/79, 3/79, 4/79, 5/79, 6/79, 7/79, 8/79, 9/79, 10/79, 11/79, 12/79, 1/80, 2/80, 3/80, 4/80, 5/80, 6/80, 7/80, 8/80, 9/80, 10/80, 11/80, 12/80, 1/81, 2/81, 3/81, 4/81, 5/81, 6/81, 7/81, 8/81, 9/81, 10/81, 11/81, 12/81, 1/82, 2/82, 3/82, 4/82, 5/82, 6/82, 7/82, 8/82, 9/82, 10/82, 11/82, 12/82, 1/83, 2/83, 3/83, 4/83, 5/83, 6/83, 7/83, 8/83, 9/83, 10/83, 11/83, 12/83, 1/84, 2/84, 3/84, 4/84, 5/84, 6/84, 7/84, 8/84, 9/84, 10/84, 11/84, 12/84, 1/85, 2/85, 3/85, 4/85, 5/85, 6/85, 7/85, 8/85, 9/85, 10/85, 11/85, 12/85, 1/86, 2/86, 3/86, 4/86, 5/86, 6/86, 7/86, 8/86, 9/86, 10/86, 11/86, 12/86, 1/87, 2/87, 3/87, 4/87, 5/87, 6/87, 7/87, 8/87, 9/87, 10/87, 11/87, 12/87, 1/88, 2/88, 3/88, 4/88, 5/88, 6/88, 7/88, 8/88, 9/88, 10/88, 11/88, 12/88, 1/89, 2/89, 3/89, 4/89, 5/89, 6/89, 7/89, 8/89, 9/89, 10/89, 11/89, 12/89, 1/90, 2/90, 3/90, 4/90, 5/90, 6/90, 7/90, 8/90, 9/90, 10/90, 11/90, 12/90, 1/91, 2/91, 3/91, 4/91, 5/91, 6/91, 7/91, 8/91, 9/91, 10/91, 11/91, 12/91, 1/92, 2/92, 3/92, 4/92, 5/92, 6/92, 7